


LEGEND

ENGINEER'S CERTIFICATION

I, DARRYL HAYTER
 being a Consulting Engineer and duly authorised representative of: -
EMPOWER ENGINEERS & PROJECT MANAGERS Pty Ltd
 hereby:-
 # certify the information contained in this drawing, prepared by DSQ survey Pty Ltd, is an accurate "as constructed" representation of the works;
 # accept responsibility for the "as constructed" information contained in this drawing; and
 # acknowledge the "as constructed" information contained in the drawing may be relied on by the UNITYWATER and other authorities.
 Certification for Stage 1 by [Signature] on 10/03/2020
 For: EMPOWER ENGINEERS & PROJECT MANAGERS Pty Ltd
 RPEQ No: 5694

REGISTERED SURVEYOR'S CERTIFICATION

I, Antony Jon Pike, hereby certify that the vertical and horizontal locations and dimensions shown on this plan are a true and correct record and were located by survey.
[Signature]
 Registered Surveyor (sig) Reg. Surveyor No. 52449 Date: 26.02.2020
 Being a duly representative of:- DSQ SURVEY PTY LTD

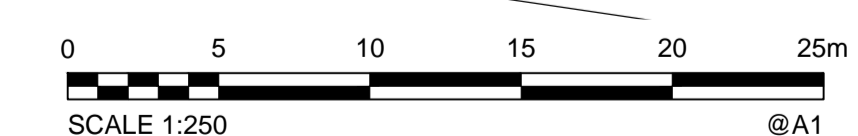

AS CONSTRUCTED

A1	A	18/12/2019	AS-CONSTRUCTED	BAS	IS				
	INDEX	DATE	REVISIONS	DRAWN	CHECKED	PASSED			

PREPARED ON BEHALF OF:

SUNSHINE COAST COUNCIL
 HILLSIDE MOOLOOLAH VALLEY STAGE 1
 COUNCIL REFERENCE: OPW18/0749.01

SCALE	1:250
SHEET	1 OF 4 SHEETS
DRAWING NO.	



LEGEND


- MAJOR CONTOUR
- MINOR CONTOUR

ENGINEER'S CERTIFICATION

* I, DARRYL HAYTER
 being a Consulting Engineer and duly authorised representative of -
EMPOWER ENGINEERS & PROJECT MANAGERS Pty Ltd
 hereby:-
 # certify the information contained in this drawing, prepared by DSQ survey Pty Ltd, is an accurate "as constructed" representation of the works;
 # accept responsibility for the "as constructed" information contained in this drawing; and
 # acknowledge the "as constructed" information contained in the drawing may be relied on by the UNITYWATER and other authorities.
 Certification for Stage 1 by D. Hayter on 10/03/2020
 For: EMPOWER ENGINEERS & PROJECT MANAGERS Pty Ltd
 RPEQ No: 5694

REGISTERED SURVEYOR'S CERTIFICATION

I, Anthony Jan Pike, hereby certify that the vertical and horizontal locations and dimensions shown on this plan are a true and correct record and were located by survey.
JP
 Registered Surveyor (sig.) Reg. Surveyor No. S2449 Date: 26.02.2020
 Being a duly representative of - DSQ SURVEY PTY LTD

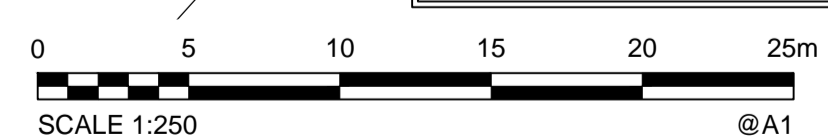

AS CONSTRUCTED

A1	INDEX	DATE	AS-CONSTRUCTED	BAS	IS	PASSED	DRAWN	CHECKED	PASSED
	A	18/12/2019	AS-CONSTRUCTED	BAS	IS				



PREPARED ON BEHALF OF:

SUNSHINE COAST COUNCIL
 HILLSIDE MOOLOOLAH VALLEY STAGE 1
 COUNCIL REFERENCE: OPW18/0749.01

SCALE	1:250
SHEET	2 OF 4 SHEETS
DRAWING NO.	



LEGEND


-  MAJOR CONTOUR
-  MINOR CONTOUR

ENGINEER'S CERTIFICATION

I, DARRYL HAYTER
 being a Consulting Engineer and duly authorised representative of: -
EMPOWER ENGINEERS & PROJECT MANAGERS Pty Ltd
 hereby:-
 # certify the information contained in this drawing, prepared by DSQ survey Pty Ltd, is an accurate "as constructed" representation of the works;
 # accept responsibility for the "as constructed" information contained in this drawing; and
 # acknowledge the "as constructed" information contained in the drawing may be relied on by the UNITYWATER and other authorities.
 Certification for Stage 1 by D.H. on 10/03/2020
 For: EMPOWER ENGINEERS & PROJECT MANAGERS Pty Ltd
 RPEQ No: 5694

REGISTERED SURVEYOR'S CERTIFICATION

I, Antony Jon Pike, hereby certify that the vertical and horizontal locations and dimensions shown on this plan are a true and correct record and were located by survey.
AP
 Registered Surveyor (sig) Reg. Surveyor No. 52449 Date: 26.02.2020
 Being a duly representative of:- DSQ SURVEY PTY LTD

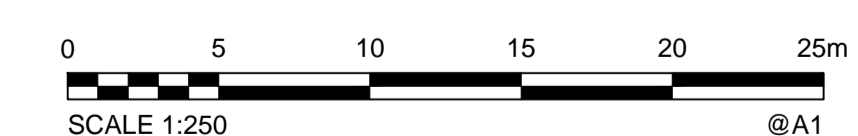

AS CONSTRUCTED

A1

INDEX	DATE	REVISIONS	DRAWN	CHECKED	PASSED
A	18/12/2019	AS-CONSTRUCTED	BAS	IS	

DRAWN	CHECKED	PASSED	INITIALS	DATE
BAS	IS			18/12/2019

PREPARED ON BEHALF OF:




 

SUNSHINE COAST COUNCIL
 HILLSIDE MOOLOOLAH VALLEY STAGE 1
 COUNCIL REFERENCE: OPW18/0749.01

SCALE	SHEET	DRAWING NO.
1:250	3 OF 4 SHEETS	



502SP308942

LEGEND


-  MAJOR CONTOUR
-  MINOR CONTOUR

ENGINEER'S CERTIFICATION

" I, DARRYL HAYTER
 being a Consulting Engineer and duly authorised representative of -
EMPOWER ENGINEERS & PROJECT MANAGERS Pty Ltd
 hereby:-
 # certify the information contained in this drawing, prepared by DSQ survey Pty Ltd, is an accurate "as constructed" representation of the works;
 # accept responsibility for the "as constructed" information contained in this drawing; and
 # acknowledge the "as constructed" information contained in the drawing may be relied on by the UNITYWATER and other authorities.
 Certification for Stage 1 by D. Hayter on 10/03/2020
 For: EMPOWER ENGINEERS & PROJECT MANAGERS Pty. Ltd.
 RPEQ No: 5694

REGISTERED SURVEYOR'S CERTIFICATION

I, Anthony Jon Pike, hereby certify that the vertical and horizontal locations and dimensions shown on this plan are a true and correct record and were located by survey.
AB 26.02.2020
 Registered Surveyor (sig) Reg. Surveyor No. S2449 Date:
 Being a duly representative of:- DSQ SURVEY PTY LTD

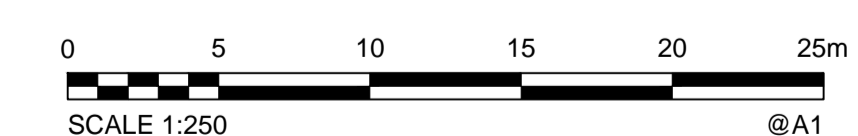

AS CONSTRUCTED

A1									
	A	18/12/2019	AS-CONSTRUCTED		BAS	IS			
INDEX	DATE	REVISIONS		DRAWN	CHECKED	PASSED		INITIALS	DATE

DRAWN	BAS	18/12/2019
CHECKED	IS	18/12/2019
PASSED		
	INITIALS	DATE

PREPARED ON BEHALF OF:




SUNSHINE COAST COUNCIL
 HILLSIDE MOOLOOLAH VALLEY STAGE 1
 COUNCIL REFERENCE: OPW18/0749.01

SCALE	1:250
SHEET	4 OF 4 SHEETS
DRAWING NO.	