

LEGEND

- EX_W — EXISTING WATER MAIN
- WATER MAIN (DN100 PVC-O PN16)
- W — WATER MAIN (DN150 PVC-O PN16)
- SERVICE PIPE (OD25 PE100 PN16)
- CONDUIT PIPE (DN100 PVC-U PN9)
- WM WATER METER - 20mm - ITRON
- FH FIRE HYDRANT
- TEE TEE (DICL)
- RED REDUCER (DICL)
- RT READY TAP
- BEND BEND (DICL)
- SV STOP/GATE VALVE

ENGINEER'S CERTIFICATION

I, DARRYL HAYTER being a Consulting Engineer and duly authorised representative of: - EMPOWER ENGINEERS & PROJECT MANAGERS Pty Ltd hereby:-


- # certify the information contained in this drawing, prepared by DSQ survey Pty Ltd, is an accurate "as constructed" representation of the works;
- # accept responsibility for the "as constructed" information contained in this drawing; and
- # acknowledge the "as constructed" information contained in the drawing may be relied on by the UNITYWATER and other authorities.

Certification for Stage 1 by D. Hayter on 10/03/2020
 For: EMPOWER ENGINEERS & PROJECT MANAGERS Pty Ltd
 RPEQ No: 5694

REGISTERED SURVEYOR'S CERTIFICATION

I, Anthony Jon Pike hereby certify that the vertical and horizontal locations and dimensions shown on this plan are a true and correct record and were located by survey.

AP
 Registered Surveyor (sig) Reg Surveyor No: S2449 Date: 26.02.2020
 Being a duly representative of:- DSQ SURVEY PTY LTD

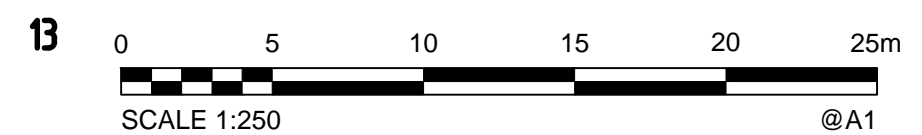

AS CONSTRUCTED


A1	C	10/03/2020	REVISIONS	BAS	LG	DRAWN	LWG	13/12/2019
	B	26/02/2020	REVISIONS	BAS	LG	CHECKED	BAS	13/12/2019
	A	13/12/2019	AS CONSTRUCTED	LWG	BAS	PASSED		
	INDEX	DATE	REVISIONS	DRAWN	CHECKED	PASSED	INITIALS	DATE



Unitywater

UW2017/011001-S1
 WATER SUPPLY RETICULATION AS CONSTRUCTED
 HILLSIDE MOOLOOLAH VALLEY
 STAGE 1

SHEET 1 OF 2 SHEETS	SCALE 1:250
REVISION DATE 10/03/2020	REVISION C
DISCIPLINE CODE	
DRAWING NO.	

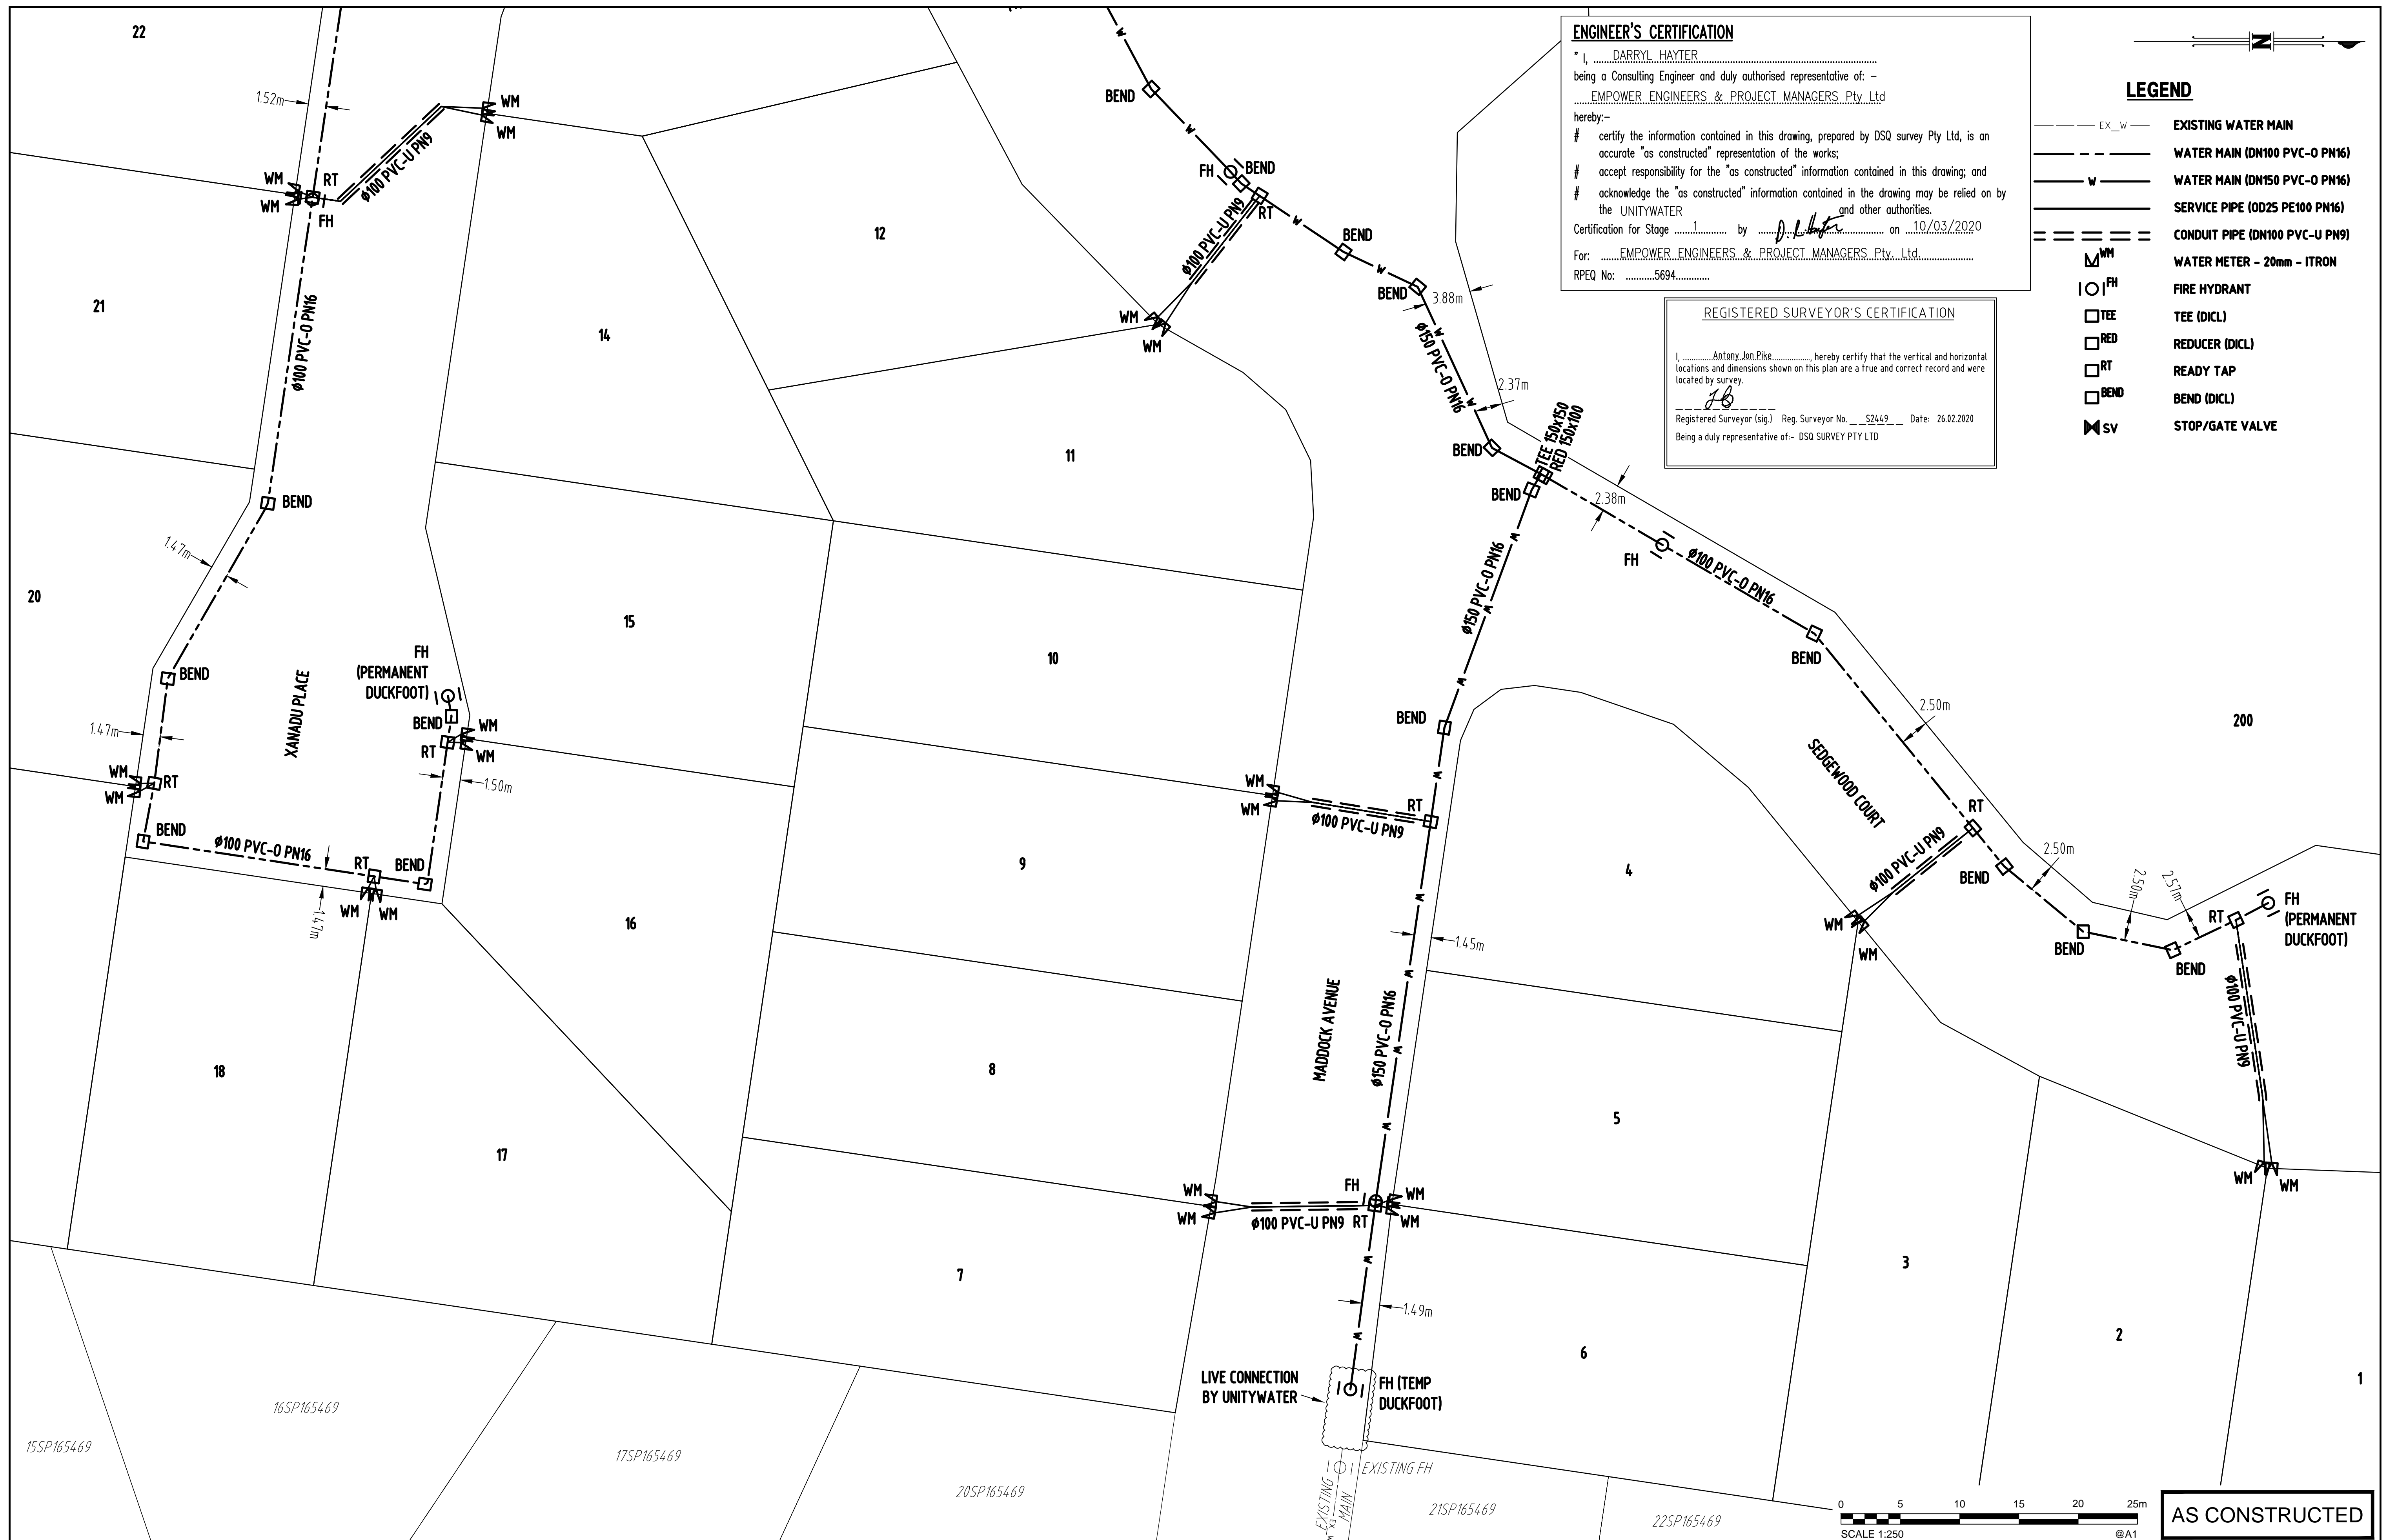


ENGINEER'S CERTIFICATION
 I, DARRYL HAYTER
 being a Consulting Engineer and duly authorised representative of: -
EMPOWER ENGINEERS & PROJECT MANAGERS Pty Ltd
 hereby:-
 # certify the information contained in this drawing, prepared by DSQ survey Pty Ltd, is an accurate "as constructed" representation of the works;
 # accept responsibility for the "as constructed" information contained in this drawing; and
 # acknowledge the "as constructed" information contained in the drawing may be relied on by the UNITYWATER and other authorities.
 Certification for Stage1..... by D. Hayter on 10/03/2020
 For: EMPOWER ENGINEERS & PROJECT MANAGERS Pty Ltd
 RPEQ No: 5694

REGISTERED SURVEYOR'S CERTIFICATION
 I, Antony Jan Pike, hereby certify that the vertical and horizontal locations and dimensions shown on this plan are a true and correct record and were located by survey.
AB
 Registered Surveyor (sig) Reg. Surveyor No. 52449 Date: 26.02.2020
 Being a duly representative of:- DSQ SURVEY PTY LTD

- LEGEND**
- EX_W --- EXISTING WATER MAIN
 - WATER MAIN (DN100 PVC-O PN16)
 - WATER MAIN (DN150 PVC-O PN16)
 - SERVICE PIPE (OD25 PE100 PN16)
 - CONDUIT PIPE (DN100 PVC-U PN9)
 - WM WATER METER - 20mm - ITRON
 - FH FIRE HYDRANT
 - TEE TEE (DICL)
 - RED REDUCER (DICL)
 - RT READY TAP
 - BEND BEND (DICL)
 - SV STOP/GATE VALVE

AS CONSTRUCTED

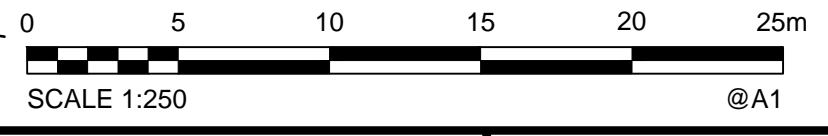

A1	C	10/03/2020	REVISIONS	BAS	LG	DRAWN	LWG	13/12/2019
	B	26/02/2020	REVISIONS	BAS	LG	CHECKED	BAS	13/12/2019
	A	13/12/2019	AS CONSTRUCTED	LWG	BAS	PASSED		
	INDEX	DATE	REVISIONS	DRAWN	CHECKED	PASSED	INITIALS	DATE

Empower
 ENGINEERS & PROJECT MANAGERS
 ABN 23 010 743 692

Unitywater

Unitywater
 UW2017/01001-S1
 WATER SUPPLY RETICULATION AS CONSTRUCTED
 HILLSIDE MOOLOOLAH VALLEY
 STAGE 1

SHEET 2 OF 2	SHEETS	SCALE 1:250
REVISION DATE	10/03/2020	REVISION C
DISCIPLINE CODE		
DRAWING NO.		